BUILDING LEGEND

1	BOATHOUSE	29	CHEMICAL STORAGE VANS	711	MILVAN
2	BIOLAB	30	SEISMIC VAULT	712	IT
3	AQUARIUM	31	EARTH STATION	713	REEFER
4	DIVE LOCKER	32	TERRA LAB (IMS)	714	REEFER
5	VOLATILE MATERIAL STORAGE	33	VHF BUILDING	716	DRY GOODS
6	CARPENTER SHOP	40	OLD VHF CONTROL BUILDING	720	GRANTEE STORAGE
7	SAUNA	41	SMALL OVERNIGHT SHACK	721	BOXES
8	SEAWATER PUMP HOUSE	101	MILVAN		
9	(DEMO)	102	MILVAN		
10	GWR	103	MILVAN		
11	T-5	104	MILVAN		
12	CLEAN AIR FACILITY-TBDEMO	105	MILVAN		
13	HAZARDOUS MATERIALS BUILDINGS	701	SCIENCE		
21	FUEL PUMP HOUSE	702	CONSUM		
22	CONICAL MONOPOLE	703	INST.		
23	EARTH STATION RADOME	705	RADIOACTIVE WASTE MILVAN		
25	COMPRESSED GAS STORAGE	706	HAZARDOUS WASTE MILVAN		
26	SEWAGE MACERATOR BUILDING	708	ADMIN		
28	FLAMMABLES STORAGE LOCKER	710	OIL SPILL		

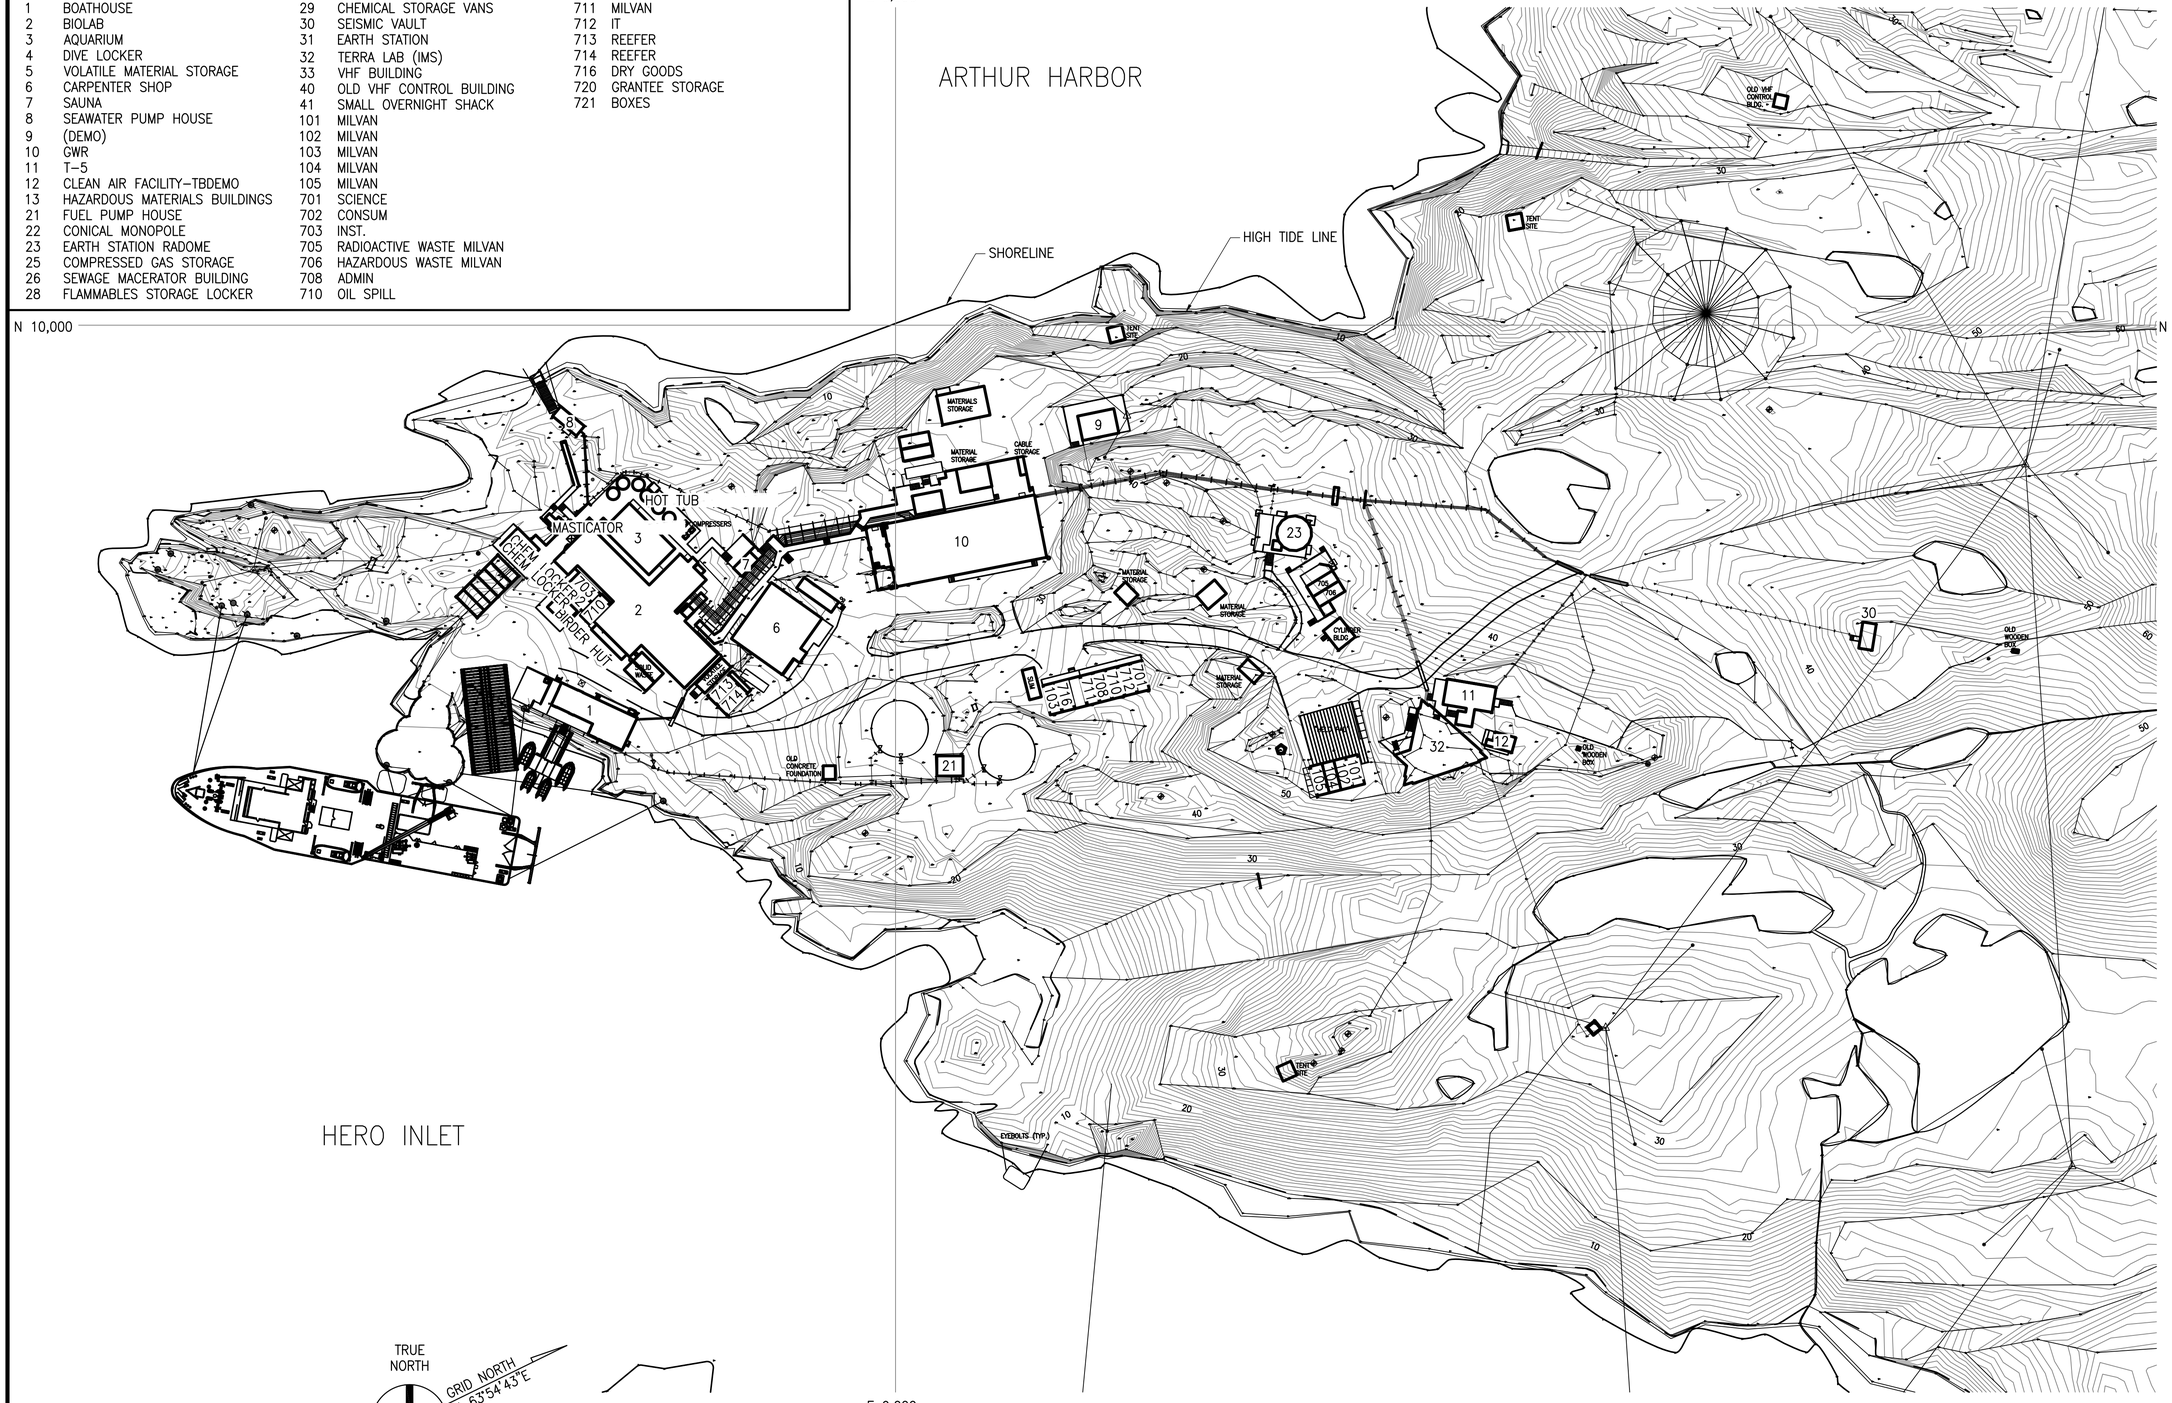

1 SITE PLAN
SCALE: 1"=100'-0"

INCHES 1 2
CENTIMETERS 1 2 3 4 5 6

NATIONAL SCIENCE FOUNDATION
OFFICE OF POLAR PROGRAMS
WASHINGTON, D.C. NSF
CONTRACT OPP. 0000373

REVISION LOG

REV.	DATE	DESCRIPTION	DFTG.	APPD.
2	01/14/15	2014-2015 AS-BUILT	MJL	
1	01/10/13	2011-2012 AS-BUILT	RJT	

PALMER STATION
STATION SITE PLAN
MASTER AS-BUILT
CIVIL

7400 South Tucson Way
Centennial, Colorado
80112-3938 USA
303-790-8606
800-688-8606

ASC ANTARCTIC SUPPORT CONTRACT

PROJECT NUMBER:

FILE NAME: PALSSPC-102-R2

DESIGNED BY:

DRAWN BY: R.TURNER

DATE CREATED: 06/28/2012

SHEET TITLE: SITE PLAN

SHEET NUMBER: C-102

1 2 3 4 5 6 7 8

A B C D